

PROFILE A.C. TO A DEPTH OF O.C4' BELOW ADJACENT GUTTER LIP AND OVERLAY WITH A.C. AS SHOWN ON TYPICAL SECTION I.

- SYMBOL INDICATES LOCATIONS THAT REQUIRE A.C. GRINDING. THE NUMBER SPECIFIES THE AREA IN SQUARE FEET TO BE PROFILED. THE NUMERAL DESIGNATES THE TYPICAL SECTION (I OR II) THAT APPLIES.
- TEST AREA (SEE SPECIAL PROVISIONS). PROFILE A.C. TO REMOVE THE EXISTING RIDGE AT THE GUTTER LIP PRIOR TO APPLYING SLURRY SEAL AS SHOWN ON TYPICAL SECTION II.

SPECIFIC CONSTRUCTION NOTES


- NUMBERS ABOVE 100 IN A HEXAGON ON THE PLAN REFER TO THE RESPECTIVE STANDARD DRAWING AND SHALL BE CONSTRUCTED ACCORDINGLY, UNLESS MODIFICATIONS ARE NOTED ON THE PLAN BELOW. ANY NUMBER SHOWN BELOW THE STANDARD DRAWING NUMBER INDICATES THE REQUIRED AMOUNT OF WORK AS NOTED.
- LOWER NUMBER INDICATES THE LENGTH, IN LINEAR FEET, OF CURB AND GUTTER TO BE REMOVED AND REPLACED, CURB FACE SHALL MATCH ADJACENT EXISTING CURB FACE HEIGHT.


GENERAL CONSTRUCTION NOTES


- TURN ALL EXISTING R26 SIGNS AND PROPOSED RBI SIGNS 45° TOWARDS THE STREET (TURNING EXISTING SIGNS ON 4 X 4 POSTS IS NOT REQUIRED).
- REMOVE ALL EXISTING BIKE LANE (BL) SIGNS.

SIGNING AND STENCIL LEGEND

- SYMBOL INDICATES PLACEMENT OF NEW SIGNS AS SHOWN WITHIN THE BOX. THE SYMBOL IS ADJACENT TO THE SIGN PLACEMENT LOCATION ON THE BIKEWAY.
- SYMBOL INDICATES THE APPROXIMATE LOCATION OF A STENCIL. THE "B" REPRESENTS THE "BIKE LANE AND ARROW", AND "B" REPRESENTS THE BICYCLE SYMBOL.

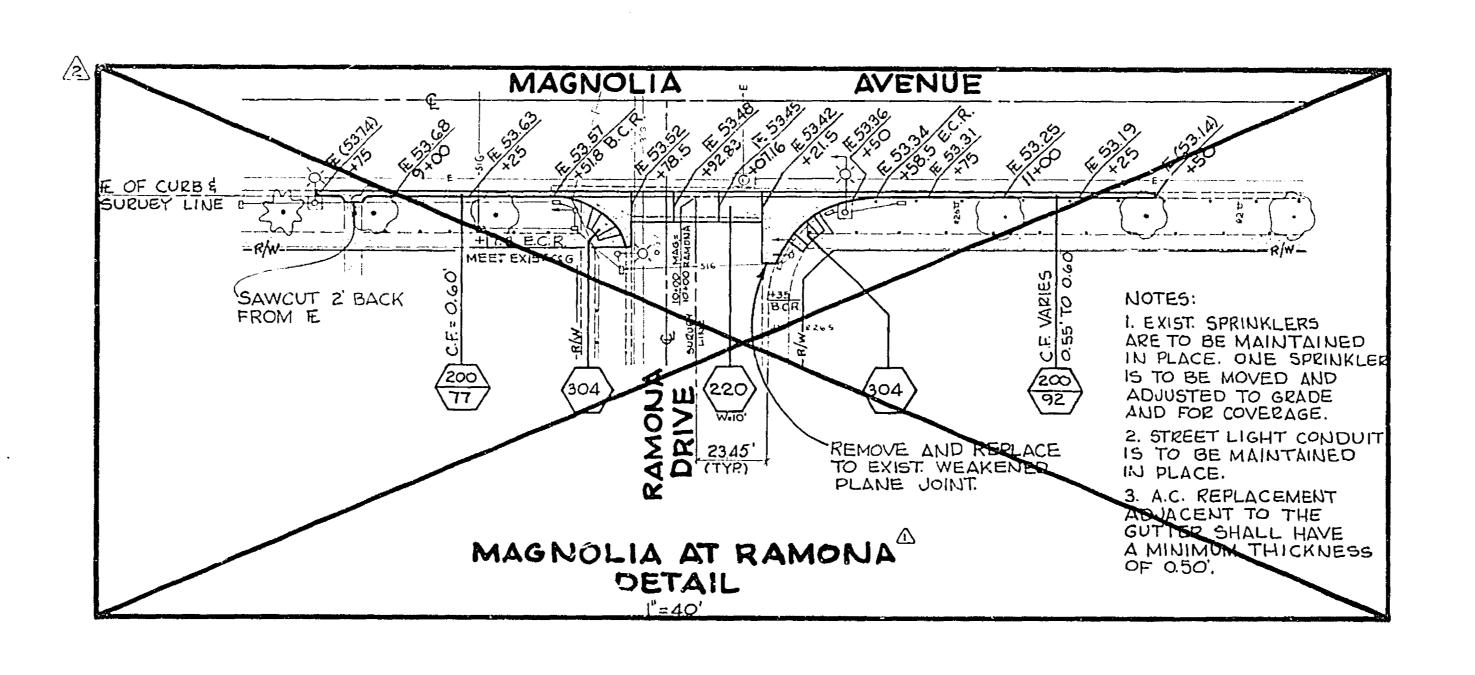

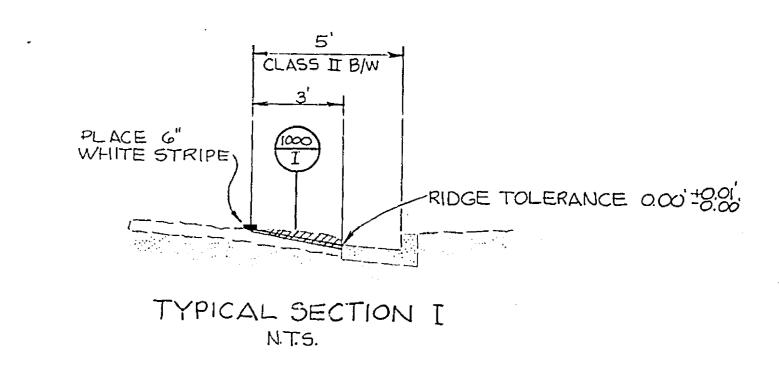

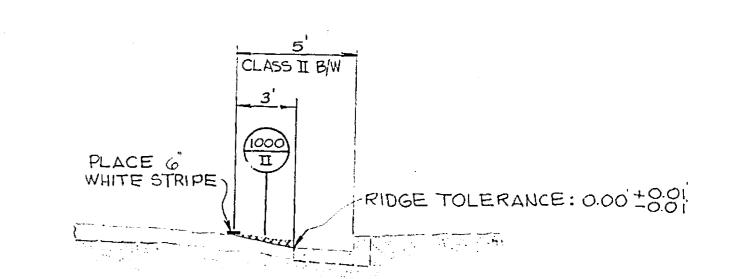

TYPICAL SECTION II N.T.S. FOR TEST AREA LARCHWOOD TO RAMONA (SEE SPECIAL PROVISIONS SEC. 3-2)

REMOVE VEGETATION FROM CRACKS AND ELIMINATE SURFACE IRREGULARITIES WITH A.C. AS DIRECTED BY ENGINEER PRIOR TO PLACE 6" WHITE STRIPE, APPLYING SLURRY SEAL. (SEE SPECIAL PROVISIONS - SECTION 302-5.8)

TYPICAL SECTION III

أرارا فالحبيم ليسربن يرتجالنيا يرسيسن ليسرنك بتبادعه الراميم الراد

| | · · · · · · · · · · · · · · · · · · · | | *AS BUILT 4/7/82 CR | INDEXED GFD |
|---|---------------------------------------|-----------------------|-------------------------|------------------------------|
| A CEG & X-GUTTER RECONSTRUCTION AT RAMONA / 1/2 /12 | CITY OF B | MERCIDE | | ACCOUNT NO. 30-575-345-04109 |
| DELETED CEG & X-GUTTER RECONSTRUCTION AT RAMONA AUX (1) 2/1/50 | PUBLIC WORKS | DEPARTMENT | MAGNOLIA AVE. BIKEWAY | 0 2072 |
| | PHINCIPAL ENGINEER PLATE BY | APPROVED BY | JURUPA TO FOURTEENTH | K-2013 |
| MARK REVISIONS APPR DATE | THAFFIC DEVISION 11-4 BOLTS | PUBLIC WORKS DIRECTOR | | SHEETI_OFI_ |
| DESIGNED BY TO DRAWN BY CR CHECKED BY CR MUK | 1 1 14 1 | DATE | HORIZ. SCALE: 1" = 200' | |